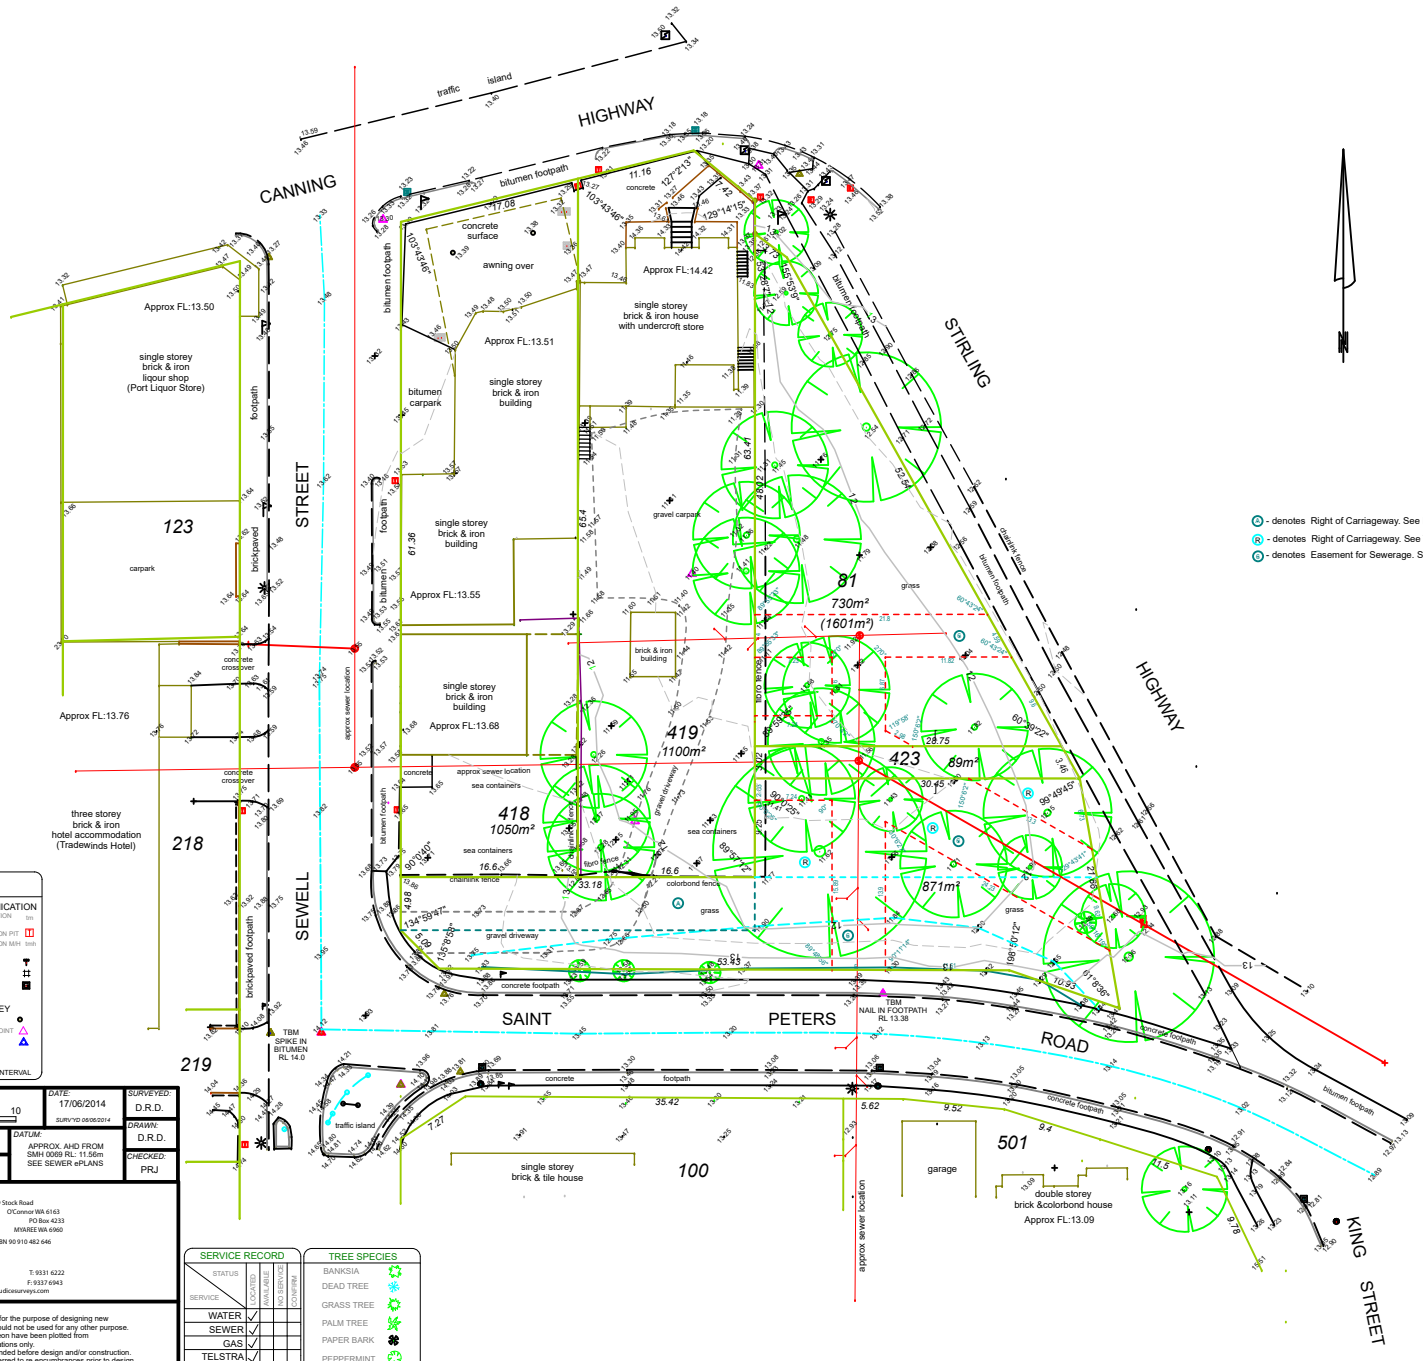

A - denotes Right of Carriageway. See L871747 & DP68130
R - denotes Right of Carriageway. See T28/1901 & DP68130
S - denotes Easement for Sewerage. Sec 27A & D 98193

SERVICE LEGEND

WATER
- STOP VALVE
- HYDRANT
- FLUSH POINT
- WATER TAP
- WATER MARKER
- WATER METER

DRAINAGE
- SW MANHOLE
- GRATE
- SIDE ENTRY PIT
- UNDEFINED MANHOLE

SEWERAGE
- SEWER MANHOLE
- INSPECT. OPENING

POWER
- CONSUMER POLE
- POWER POLE
- LIGHT POLE
- STAY POLE
- S.WIRE ANCHOR
- U.G CABLE BOX
- CABLE M/H
- CABLE DOME

TELECOMMUNICATION
- TELECOMMUNICATION MARKER
- TELECOMMUNICATION PIT
- TELECOMMUNICATION M/H

GAS
- GAS MARKER
- GAS METER
- GAS VALVE

LINE STYLES
- BASE OF BRICKWALL
- SEWER LINE
- TOP OF BANK
- BASE OF BANK
- POWER LINE
- FENCE
- BOUNDARY
- WINDOW
- ROAD CENTRELINE
- TOP OF L/STONE WALL
- BASE OF L/STONE WALL
- BUILDING LINE
- TOP OF KERB
- BASE OF KERB

FEATURES
- STREET SIGN
- CLOTHES HOIST
- TRAFFIC LIGHTS
- GATE

SURVEY
- PEG FOUND
- CONTROL POINT
- DATUM

0.5m CONTOUR INTERVAL

LOT:	PLAN/DIAG:	C/T: VOL / FOL
81	DP69681	2788-988
418	P 1753	1938-760
419	P 1753	1934-160
423	P 1753	792-1

REVISION:

SCALE: @ A1 1:250 (0 5 10)

DATE: 17/06/2014 SURV'YD 06/06/2014

SURVEYED: D.R.D.

DRAWN: D.R.D.

REF: 134/14-DET

WAPC REF:

DATUM: APPROX. AHD FROM SMH 0069 RL: 11.56m SEE SEWER ePLANS

CHECKED: PRJ

GIUDICE SURVEYS
ESTABLISHED 1972
LICENSED LAND SURVEYORS
Consultants,
Engineering Surveys, Project Management
Email: giudice@giudicesurveys.com

First Floor, 289 Stock Road
O'Connor WA 6163
PO Box 4233
MYAREE WA 6960
ABN 90 910 482 646

T: 9331 6222
F: 9337 6943
http://www.giudicesurveys.com

TITLE:
FEATURE & CONTOUR SURVEY
LOTS 81, 418, 419 & 423 CANNING HIGHWAY
EAST FREMANTLE

CLIENT:
BUILTFORM PROJECTS

PLEASE NOTE:
This drawing has been prepared for the purpose of designing new constructions on the land and should not be used for any other purpose.
* The title boundaries shown hereon have been plotted from plan dimensions,fence/wall locations only.
* Boundary redefinition recommended before design and/or construction.
* Certificate of Title should be referred to re encumbrances prior to design
* Only visible services have been located. Prior to any demolition, construction, or excavation the relevant authorities should be contacted for detailed location of all services.
* The position of sewer line shown is indicative only and Water Authority as-constructed plans should be referred to prior to design.
* Approx FL taken at Threshold of Door
* This note forms an integral part of this plan.

13414DET - A1 det

SERVICE RECORD

SERVICE \ STATUS	LOCATED	AVAILABLE	NO SERVICE	CONFIRM
WATER	✓			
SEWER	✓			
GAS	✓			
TELSTRA	✓			
POWER U/G	✓			
O/H				

NOTE: Services marked 'CONFIRM' require builder/client to confirm position on site.

TREE SPECIES

- BANKSIA
- DEAD TREE
- GRASS TREE
- PALM TREE
- PAPER BARK
- PEPPERMINT
- PINE TREE
- SHE OAK
- TREE UNNAMED